

KEY	
	EXISTING FORECOURT (NO CIVIL WORKS)
	EXISTING COBBLE STONE SETS TO BE RE-LAID TO SUIT NEW LEVELS OVER 50mm STEINTEC BEDDING AND GROUTING MORTAR
	EXISTING GRANITE SETS TO BE RETAINED
	EXISTING PRIVATE FORECOURT (TO BE RE-PAVED WITH PROPOSED 750x600x63mm ASP SLABS LAID ON 100mm C16/20 CONCRETE BASE AND 50mm SAND/CEMENT BEDDING)
	PROPOSED 750x600x63mm FIBRE REINFORCED ASP SLABS LAID ON 150mm C16/20 CONCRETE BASE AND 50mm SAND/CEMENT BEDDING
	PROPOSED 750x600x50mm YORKSTONE PAVERS LAID ON 75mm THICK C8/10 CONCRETE AND 30mm TYPE 35 HIGH STRENGTH BEDDING MORTAR AND 6 TO 8MM TYPE 40 GROUTING COLOUR BUFF GREY
	EXISTING YORKSTONE BEDDING TO BE RELAID
	PROPOSED 300x600x75mm GREY BEIGE GRANITE LAID ON 150mm C16/20 CONCRETE BASE AND 50mm STEINTEC BEDDING AND GROUTING MORTAR WITH HD GUARD
	PROPOSED 250x150x100mm GREY BEIGE GRANITE LAID ON 150mm C16/20 CONCRETE BASE AND 50mm STEINTEC BEDDING AND GROUTING MORTAR WITH HD GUARD
	PROPOSED 300x300x70mm CAITHNESS FLAG LAID ON 150mm C16/20 CONCRETE BASE AND 50mm STEINTEC BEDDING AND GROUTING MORTAR WITH HD GUARD
	PROPOSED 50mm HRA 35/14 F surf 40/60 PMB + WTR2 CARRIAGEWAY SURFACE WITH 14/20 PRE-COATED CHIPPINGS SURFACE COURSE ON EXISTING BINDER COURSE (SPEC TO BE CONFIRMED WITH WCC & FMC BEFORE CONSTRUCTION)
	PROPOSED 600mm NEW CARRIAGEWAY, 50mm HRA 35/14 F surf 40/60 PMB + WTR2 CARRIAGEWAY SURFACE WITH 14/20 PRE-COATED CHIPPINGS SURFACE COURSE, 50mm (MIN) HRA 50/14 bin 40/60 PMB WTR2 BINDER COURSE, 200mm SRC C20 CONCRETE BASE AND 300mm TYPE 1 (SPEC TO BE CONFIRMED WITH WCC & FMC BEFORE CONSTRUCTION)
	EXISTING PRIVATE FORECOURT TO BE PAVED WITH A LAYER OF CONCRETE UP TO 70mm (SPEC TO BE CONFIRMED ON SITE)
	PROPOSED 400x400x63mm FIBRE REINFORCED ASP BLUSTER TACTILE SLABS LAID ON 150mm C16/20 CONCRETE BASE AND 50mm SAND/CEMENT BEDDING

REV	DATE	BY	DESCRIPTION	CHK	APP
S6-P01	12.02.2024	-	FIRST ISSUE	-	-

DRAWING STATUS: **AS BUILT**

25 Mandela Way, London, SE1 5SZ  
www.fmcproject.co.uk www.wsp.com

CITY OF WESTMINSTER logo

PROJECT: ST JOHN'S WOOD HIGH STREET PUBLIC REALM IMPROVEMENTS

TITLE: GENERAL ARRANGEMENT SHEET 01 OF 03

SCALE @ A1	DATE	DESIGN/DRAWN	CHECKED	APPROVED	SHEET
1:250	12.02.2024	-	-	-	A1
WSP PROJECT NO.	FMC PROJECT NO.	WCC PROJECT NO.			
70086238	WWESA2867	C.WD13434			
DRAWING NO.	REV				
70086238-WSP-P01-X-DR-HI-0100-01	S6-P01				

**ADDITIONAL KEY**

	PROPOSED SINUSOIDAL RAMP		PROPOSED STAINLESS STEEL STUD FLAT DELINEATOR STUD		EXISTING LINE MARKING
	PROPOSED NEW 150x300mm GRANITE KERB LAID ON 150mm C16/20 WET LEAN CONCRETE		PROPOSED BRICK CATCH PIT (WESTMINSTER STANDARD DRAWING SD-05-21) WITH INSTALL CLASS D400 HEAVY DUTY FRAME AND CYCLE FRIENDLY COVER (450 x 450mm)		EXISTING BOLLARD
	PROPOSED NEW 300x200mm GRANITE KERB LAID ON 150mm C16/20 WET LEAN CONCRETE		EXISTING GULLY FRAME AND COVER TO BE REPLACED WITH CLASS D400 CYCLE FRIENDLY FRAME AND COVER GRATING		EXISTING WESTMINSTER BOLLARD
	PROPOSED NEW 300x200mm FLUSH GRANITE KERB WITH DROPPER LAID ON 150mm C16/20 WET LEAN CONCRETE		EXISTING VENT TO BE RAISED/LOWERED TO SUIT NEW LEVELS		EXISTING LAMP COLUMN / EXISTING POST
	PROPOSED PRIMROSE YELLOW LINE MARKING		PROPOSED SIGN AND POST		EXISTING BELISHA BEACON
	PROPOSED WHITE LINE MARKING		PROPOSED LAMP COLUMN		EXISTING SIGN AND POST
	PROPOSED 300x750x63mm FIBRE REINFORCED ASP SLABS LAID ON 150mm C16/20 CONCRETE BASE AND 50mm SAND/CEMENT BEDDING		PROPOSED COMBINED LAMP COLUMN AND BELISHA BEACON		EXISTING ELECTRICAL CHARGING POINT
	NEW 900x600mm MANHOLE WITH HEAVY DUTY DOUBLE RECESSED COVER AND FRAME ACCORDING TO WESTMINSTER STANDARD DETAIL SD-05-04		PROPOSED DORIC BOLLARD		EXISTING GULLY
	PROPOSED GULLY POT TYPE 1 (450mm DIA x 900mm DEPTH) WITH CLASS D400 HEAVY DUTY FRAME AND CYCLE FRIENDLY COVER (450 x 450mm)		PROPOSED BELISHA BEACON (FOR DETAILS REFER TO 70086238-WSP-P01-X-DR-LI-1300)		EXISTING HOPPER BOX
	PROPOSED GULLY POT TYPE 1 (450mm DIA x 900mm DEPTH) WITH CLASS D400 HEAVY DUTY FRAME AND STANDARD COVER (450 x 450mm)		PROPOSED MINI FEEDER PILLAR		EXISTING CYCLE STAND
	PROPOSED GULLY POT TYPE 1 (450mm DIA x 900mm DEPTH) WITH CLASS D400 HEAVY DUTY FRAME AND STANDARD COVER (450 x 450mm)		PROPOSED WALL MOUNTED LIGHT		EXISTING TREE
	PROPOSED GULLY POT TYPE 1 (450mm DIA x 900mm DEPTH) WITH CLASS D400 HEAVY DUTY FRAME AND STANDARD COVER (450 x 450mm)		PROPOSED TYPE 1 CYCLE STAND		EXISTING BIN
	PROPOSED GULLY POT TYPE 1 (450mm DIA x 900mm DEPTH) WITH CLASS D400 HEAVY DUTY FRAME AND STANDARD COVER (450 x 450mm)		PROPOSED TYPE 2 CYCLE STAND		EXISTING BENCH
	PROPOSED SINUSOIDAL RAMP		EXISTING COAL HOLE TO REMAIN IN SITU		EXISTING TELEPHONE BOX
	PROPOSED SINUSOIDAL RAMP		EXISTING KERB TO BE RETAINED		EXISTING ELECTRICAL CABINET
	PROPOSED SINUSOIDAL RAMP		EXISTING CATENARY FESTIVE LIGHTING TO BE RETAINED		EXISTING GRIT BOX


This map is reproduced from Ordnance Survey material with the permission of Ordnance Survey on behalf of the Controller of Her Majesty's Stationery Office © Crown copyright. Unauthorised reproduction infringes Crown copyright and may lead to prosecution or civil proceedings. (WCC/LA 100019597)

**ADDITIONAL KEY**

- PROPOSED SINUSOIDAL RAMP
- PROPOSED NEW 150x300mm GRANITE KERB LAID ON 150mm C16/20 WET LEAN CONCRETE
- PROPOSED NEW 300x200mm GRANITE KERB LAID ON 150mm C16/20 WET LEAN CONCRETE
- PROPOSED NEW 300x200mm FLUSH GRANITE KERB WITH DROPPER LAID ON 150mm C16/20 WET LEAN CONCRETE
- PROPOSED PRIMROSE YELLOW LINE MARKING
- PROPOSED WHITE LINE MARKING
- PROPOSED 300x750x63mm FIBRE REINFORCED ASP SLABS LAID ON 150mm C16/20 CONCRETE BASE AND 50mm SAND/CEMENT BEDDING
- NEW 900x600mm MANHOLE WITH HEAVY DUTY DOUBLE RECESSED COVER AND FRAME ACCORDING TO WESTMINSTER STANDARD DETAIL SD-05-04
- PROPOSED GULLY POT TYPE 1 (450mm DIA x 900mm DEPTH) WITH CLASS D400 HEAVY DUTY FRAME AND CYCLE FRIENDLY COVER (450 x 450mm)
- PROPOSED GULLY POT TYPE 2 (375mm DIA x 750mm DEPTH) WITH 300x300mm PEDESTRIAN FRAME FACTA D DU507C DUREY CASTINGS GRATING AND FRAME
- PROPOSED BRICK CATCH PIT (WESTMINSTER STANDARD DRAWING SD-05-21) WITH INSTALL CLASS D400 HEAVY DUTY FRAME AND CYCLE FRIENDLY COVER (450 x 450mm)
- EXISTING GULLY FRAME AND COVER TO BE REPLACED WITH CLASS D400 CYCLE FRIENDLY FRAME AND COVER GRATING
- EXISTING VENT TO BE RAISED/LOWERED TO SUIT NEW LEVELS
- PROPOSED SIGN AND POST
- PROPOSED LAMP COLUMN
- PROPOSED COMBINED LAMP COLUMN AND BELISHA BEACON
- PROPOSED BELISHA BEACON (FOR DETAILS REFER TO 70086238-WSP-P01-X-DR-LI-1300)
- PROPOSED MINI FEEDER PILLAR
- PROPOSED WALL MOUNTED LIGHT
- PROPOSED TYPE 1 CYCLE STAND
- PROPOSED TYPE 2 CYCLE STAND
- PROPOSED STAINLESS STEEL STUD FLAT DELINEATOR STUD
- PROPOSED TREE  
BETULA KENAICA (LEFT) /  
MAGNOLIA KOBUS (MIDDLE) /  
SORBUS INTERMEDIA (RIGHT)
- PROPOSED 1.2x1.2M ARBORESIN TREE GRILLE, FILLED WITH ADDAFLEX MATERIAL. COLOUR GS/01/52 A FOR TREE PIT
- PROPOSED 1.5x1.5M ARBORESIN TREE GRILLE, FILLED WITH ADDAFLEX MATERIAL. COLOUR GS/01/52 A LAID ON 100mm OF 40mm FREE DRAINING CRUSHED STONE
- PROPOSED 2.58M WESTMINSTER BENCH WITH CENTRE LEG (BACKLESS)
- PROPOSED 2.58M WESTMINSTER BENCH WITH CENTRE LEG (WITH A BACK)
- RELOCATED LITTER BIN
- RELOCATED STREETNAME PLATE (LOCATION TO BE CONFIRMED WITH WCC)
- EXISTING COVER TO BE RAISED/LOWERED TO SUIT NEW LEVELS
- EXISTING SERVICE COVER TO BE RECESSED
- EXISTING COAL HOLE TO REMAIN IN SITU
- EXISTING KERB TO BE RETAINED
- EXISTING LINE MARKING
- EXISTING BOLLARD
- EXISTING WESTMINSTER BOLLARD
- EXISTING LAMP COLUMN / EXISTING POST
- EXISTING BELISHA BEACON
- EXISTING SIGN AND POST
- EXISTING ELECTRICAL CHARGING POINT
- EXISTING GULLY
- EXISTING HOPPER BOX
- EXISTING CYCLE STAND
- EXISTING TREE
- EXISTING BIN
- EXISTING BENCH
- EXISTING TELEPHONE BOX
- EXISTING ELECTRICAL CABINET
- EXISTING GRIT BOX
- EXISTING CATENARY FESTIVE LIGHTING TO BE RETAINED

**KEY**

- EXISTING FORECOURT (NO CIVIL WORKS)
- EXISTING COBBLED STONE SETS TO BE RE-LAID TO SUIT NEW LEVELS OVER 50mm STEINTEC BEDDING AND GROUTING MORTAR
- EXISTING GRANITE SETS TO BE RETAINED
- EXISTING PRIVATE FORECOURT (TO BE RE-PAVED WITH PROPOSED 750x600x63mm ASP SLABS LAID ON 100mm C16/20 CONCRETE BASE AND 50mm SAND/CEMENT BEDDING)
- PROPOSED 750x600x63mm FIBRE REINFORCED ASP SLABS LAID ON 150mm C16/20 CONCRETE BASE AND 50mm SAND/CEMENT BEDDING
- PROPOSED 750x600x50mm YORKSTONE PAVERS LAID ON 75mm THICK C8/10 CONCRETE AND 30mm TYPE 35 HIGH STRENGTH BEDDING MORTAR AND 6 TO 8MM TYPE 40 GROUTING COLOUR BUFF GREY
- EXISTING YORKSTONE BEDDING TO BE RELAID
- PROPOSED 300x600x75mm GREY BEIGE GRANITE LAID ON 150mm C16/20 CONCRETE BASE AND 50mm STEINTEC BEDDING AND GROUTING MORTAR WITH HD GUARD
- PROPOSED 250x150x100mm GREY BEIGE GRANITE LAID ON 150mm C16/20 CONCRETE BASE AND 50mm STEINTEC BEDDING AND GROUTING MORTAR WITH HD GUARD
- PROPOSED 300x300x70mm CAITHNESS FLAG LAID ON 150mm C16/20 CONCRETE BASE AND 50mm STEINTEC BEDDING AND GROUTING MORTAR WITH HD GUARD
- PROPOSED 50mm HRA 35/14 F surf 40/60 PMB + WTR2 CARRIAGEWAY SURFACE WITH 14/20 PRE-COATED CHIPPINGS SURFACE COURSE ON EXISTING BINDER COURSE (SPEC TO BE CONFIRMED WITH WCC & FMC BEFORE CONSTRUCTION)
- PROPOSED 600mm NEW CARRIAGEWAY, 50mm HRA 35/14 F surf 40/60 PMB + WTR2 CARRIAGEWAY SURFACE WITH 14/20 PRE-COATED CHIPPINGS SURFACE COURSE, 50mm (MIN) HRA 50/14 bin 40/60 PMB WTR2 BINDER COURSE, 200mm SRC C20 CONCRETE BASE AND 300mm TYPE 1 (SPEC TO BE CONFIRMED WITH WCC & FMC BEFORE CONSTRUCTION)
- EXISTING PRIVATE FORECOURT TO BE PAVED WITH A LAYER OF CONCRETE UP TO 70mm (SPEC TO BE CONFIRMED ON SITE)
- PROPOSED 400x400x63mm FIBRE REINFORCED ASP BLUSTER TACTILE SLABS LAID ON 150mm C16/20 CONCRETE BASE AND 50mm SAND/CEMENT BEDDING

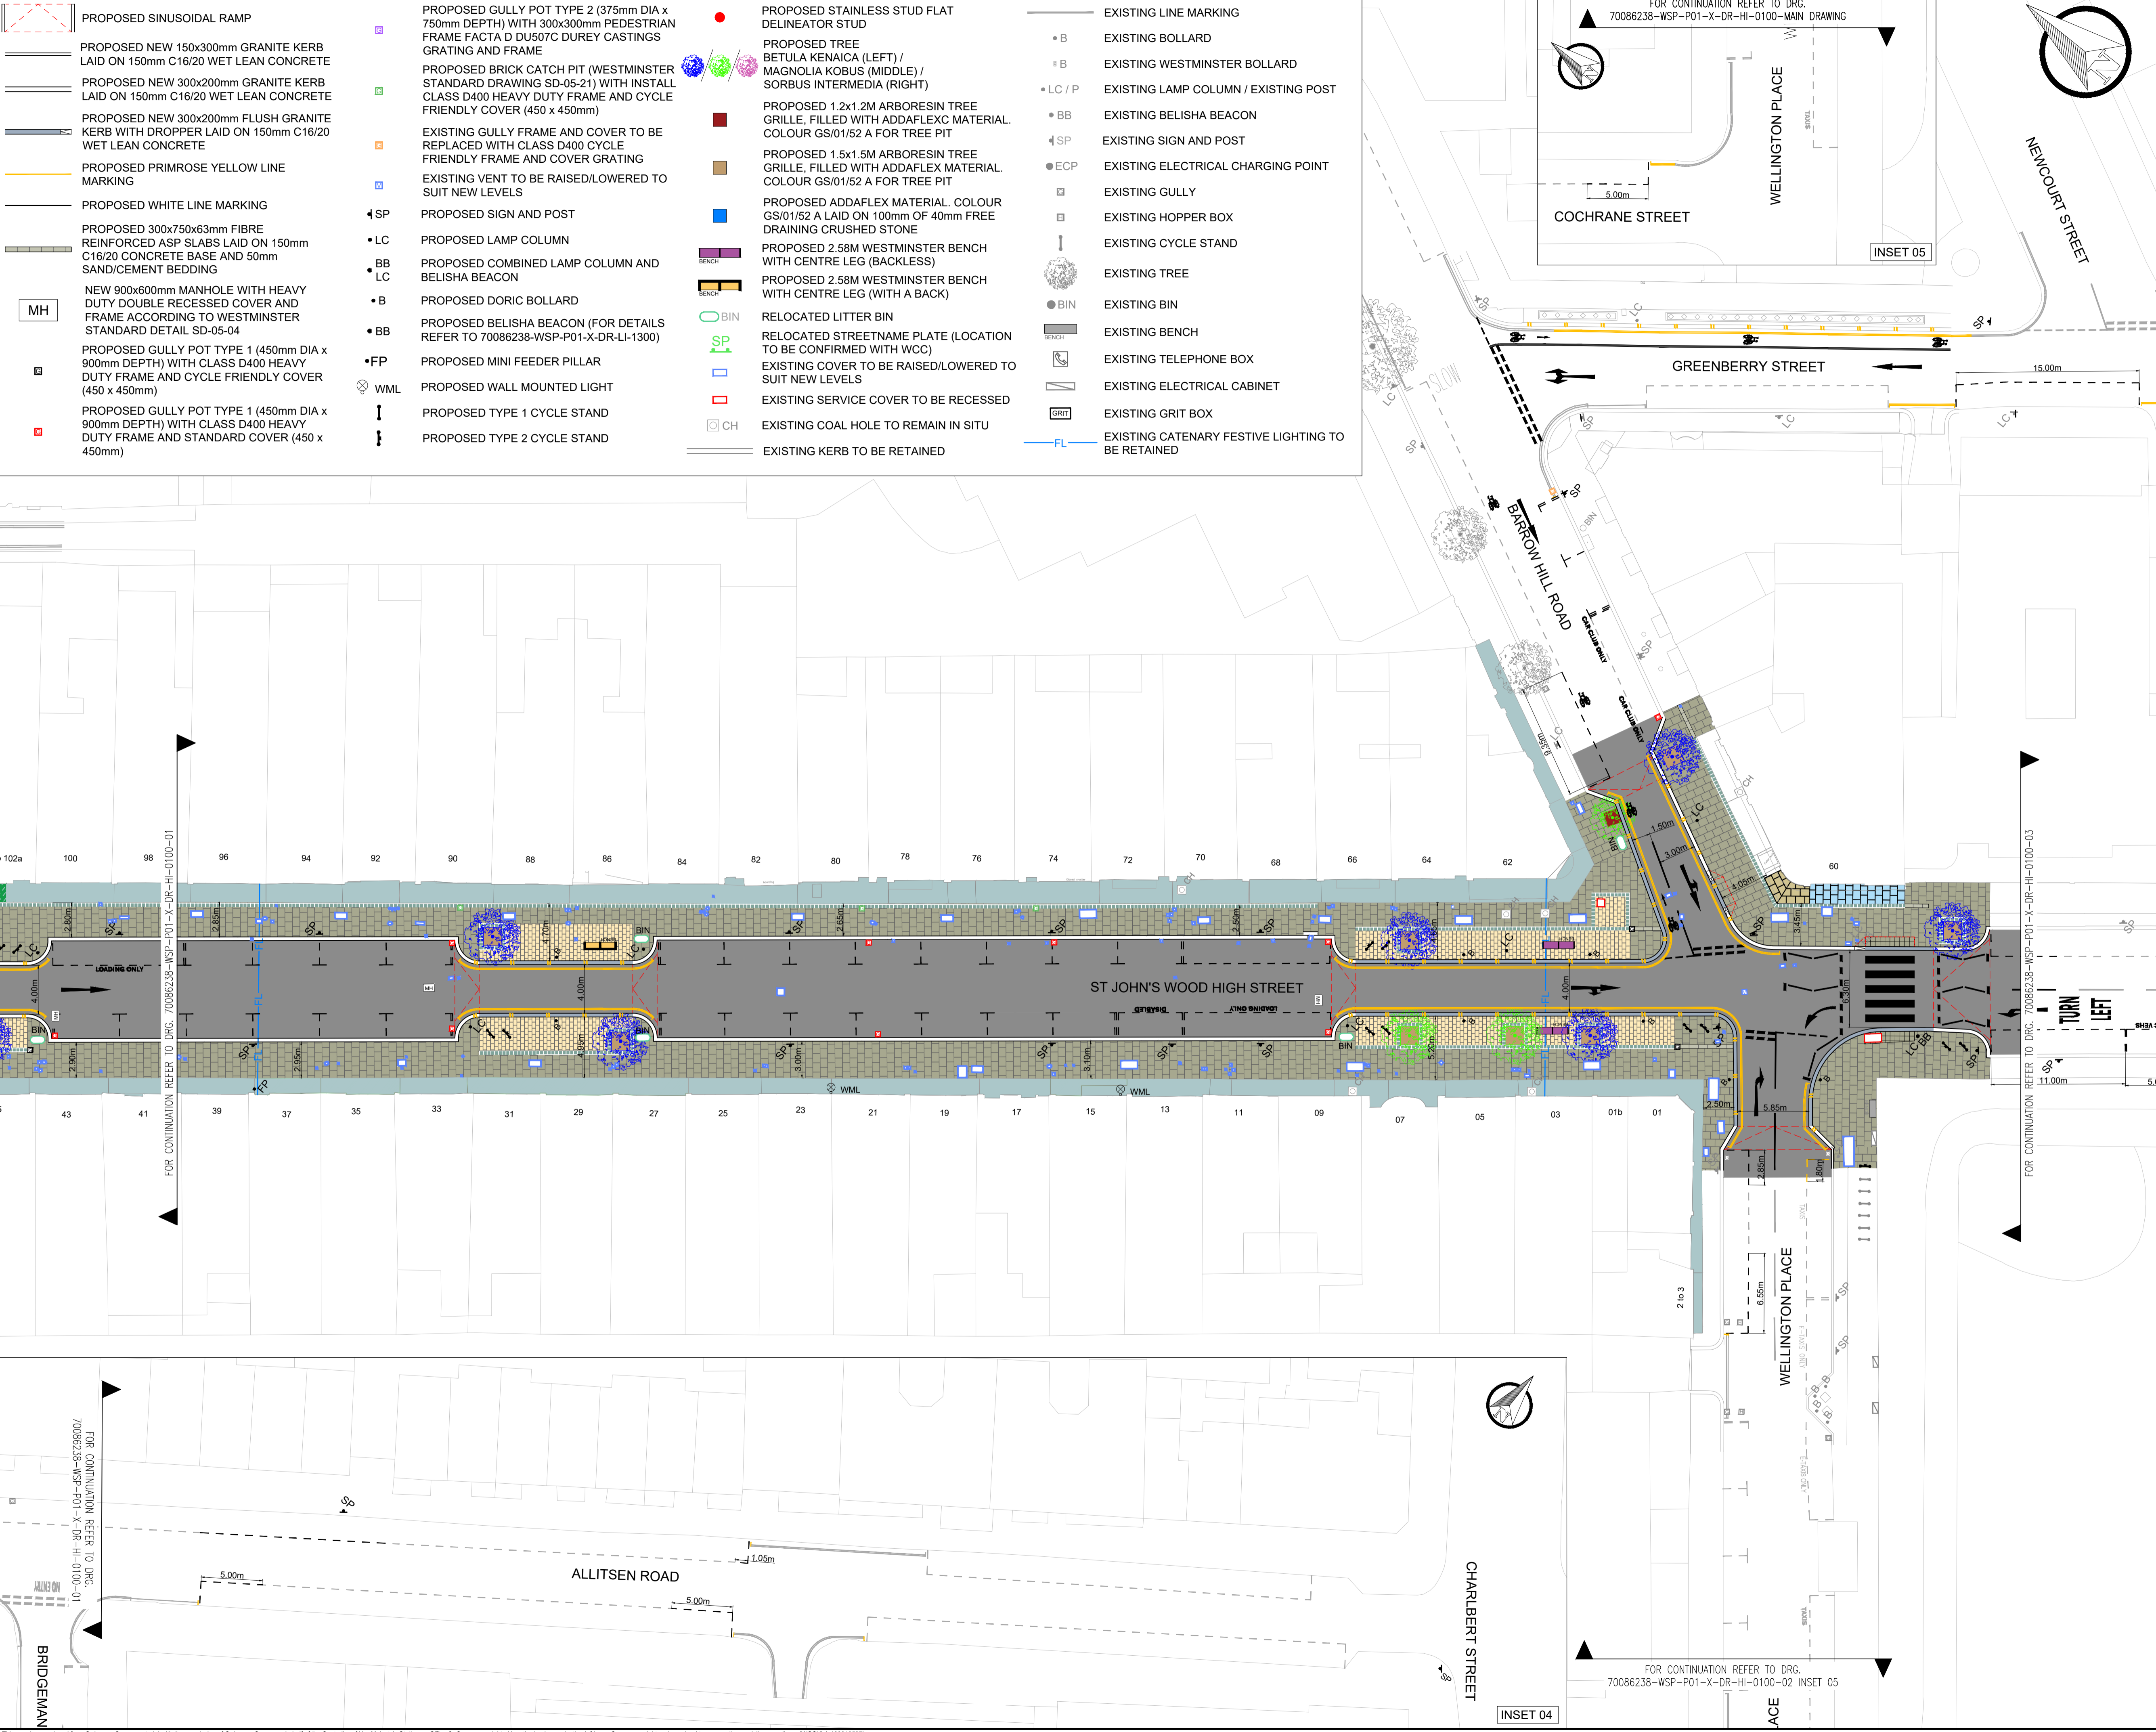

REV	DATE	BY	DESCRIPTION	CHK	APD
S6-P01	12.02.2024	-	FIRST ISSUE	-	-

DRAWING STATUS: **AS BUILT**

25 Mandela Way, London, SE1 5SZ  
www.fmcconway.co.uk www.wsp.com


CLIENT: **City of Westminster**

PROJECT: **ST JOHNS WOOD HIGH STREET PUBLIC REALM IMPROVEMENTS**

TITLE: **GENERAL ARRANGEMENT SHEET 02 OF 03**

SCALE @ A1	DATE	DESIGN/DRAWN	CHECKED	APPROVED	SHEET
1:250	12.02.2024	-	-	-	A1
WSP PROJECT NO.	FMC PROJECT NO.	WCC PROJECT NO.			
70086238	WWESA2867	C.WD13434			
DRAWING NO.	REV				
70086238-WSP-P01-X-DR-HI-0100-02	S6-P01				

This map is reproduced from Ordnance Survey material with the permission of Ordnance Survey on behalf of the Controller of Her Majesty's Stationery Office © Crown copyright. Unauthorised reproduction infringes Crown copyright and may lead to prosecution or civil proceedings. (WCC/LA 100019597)

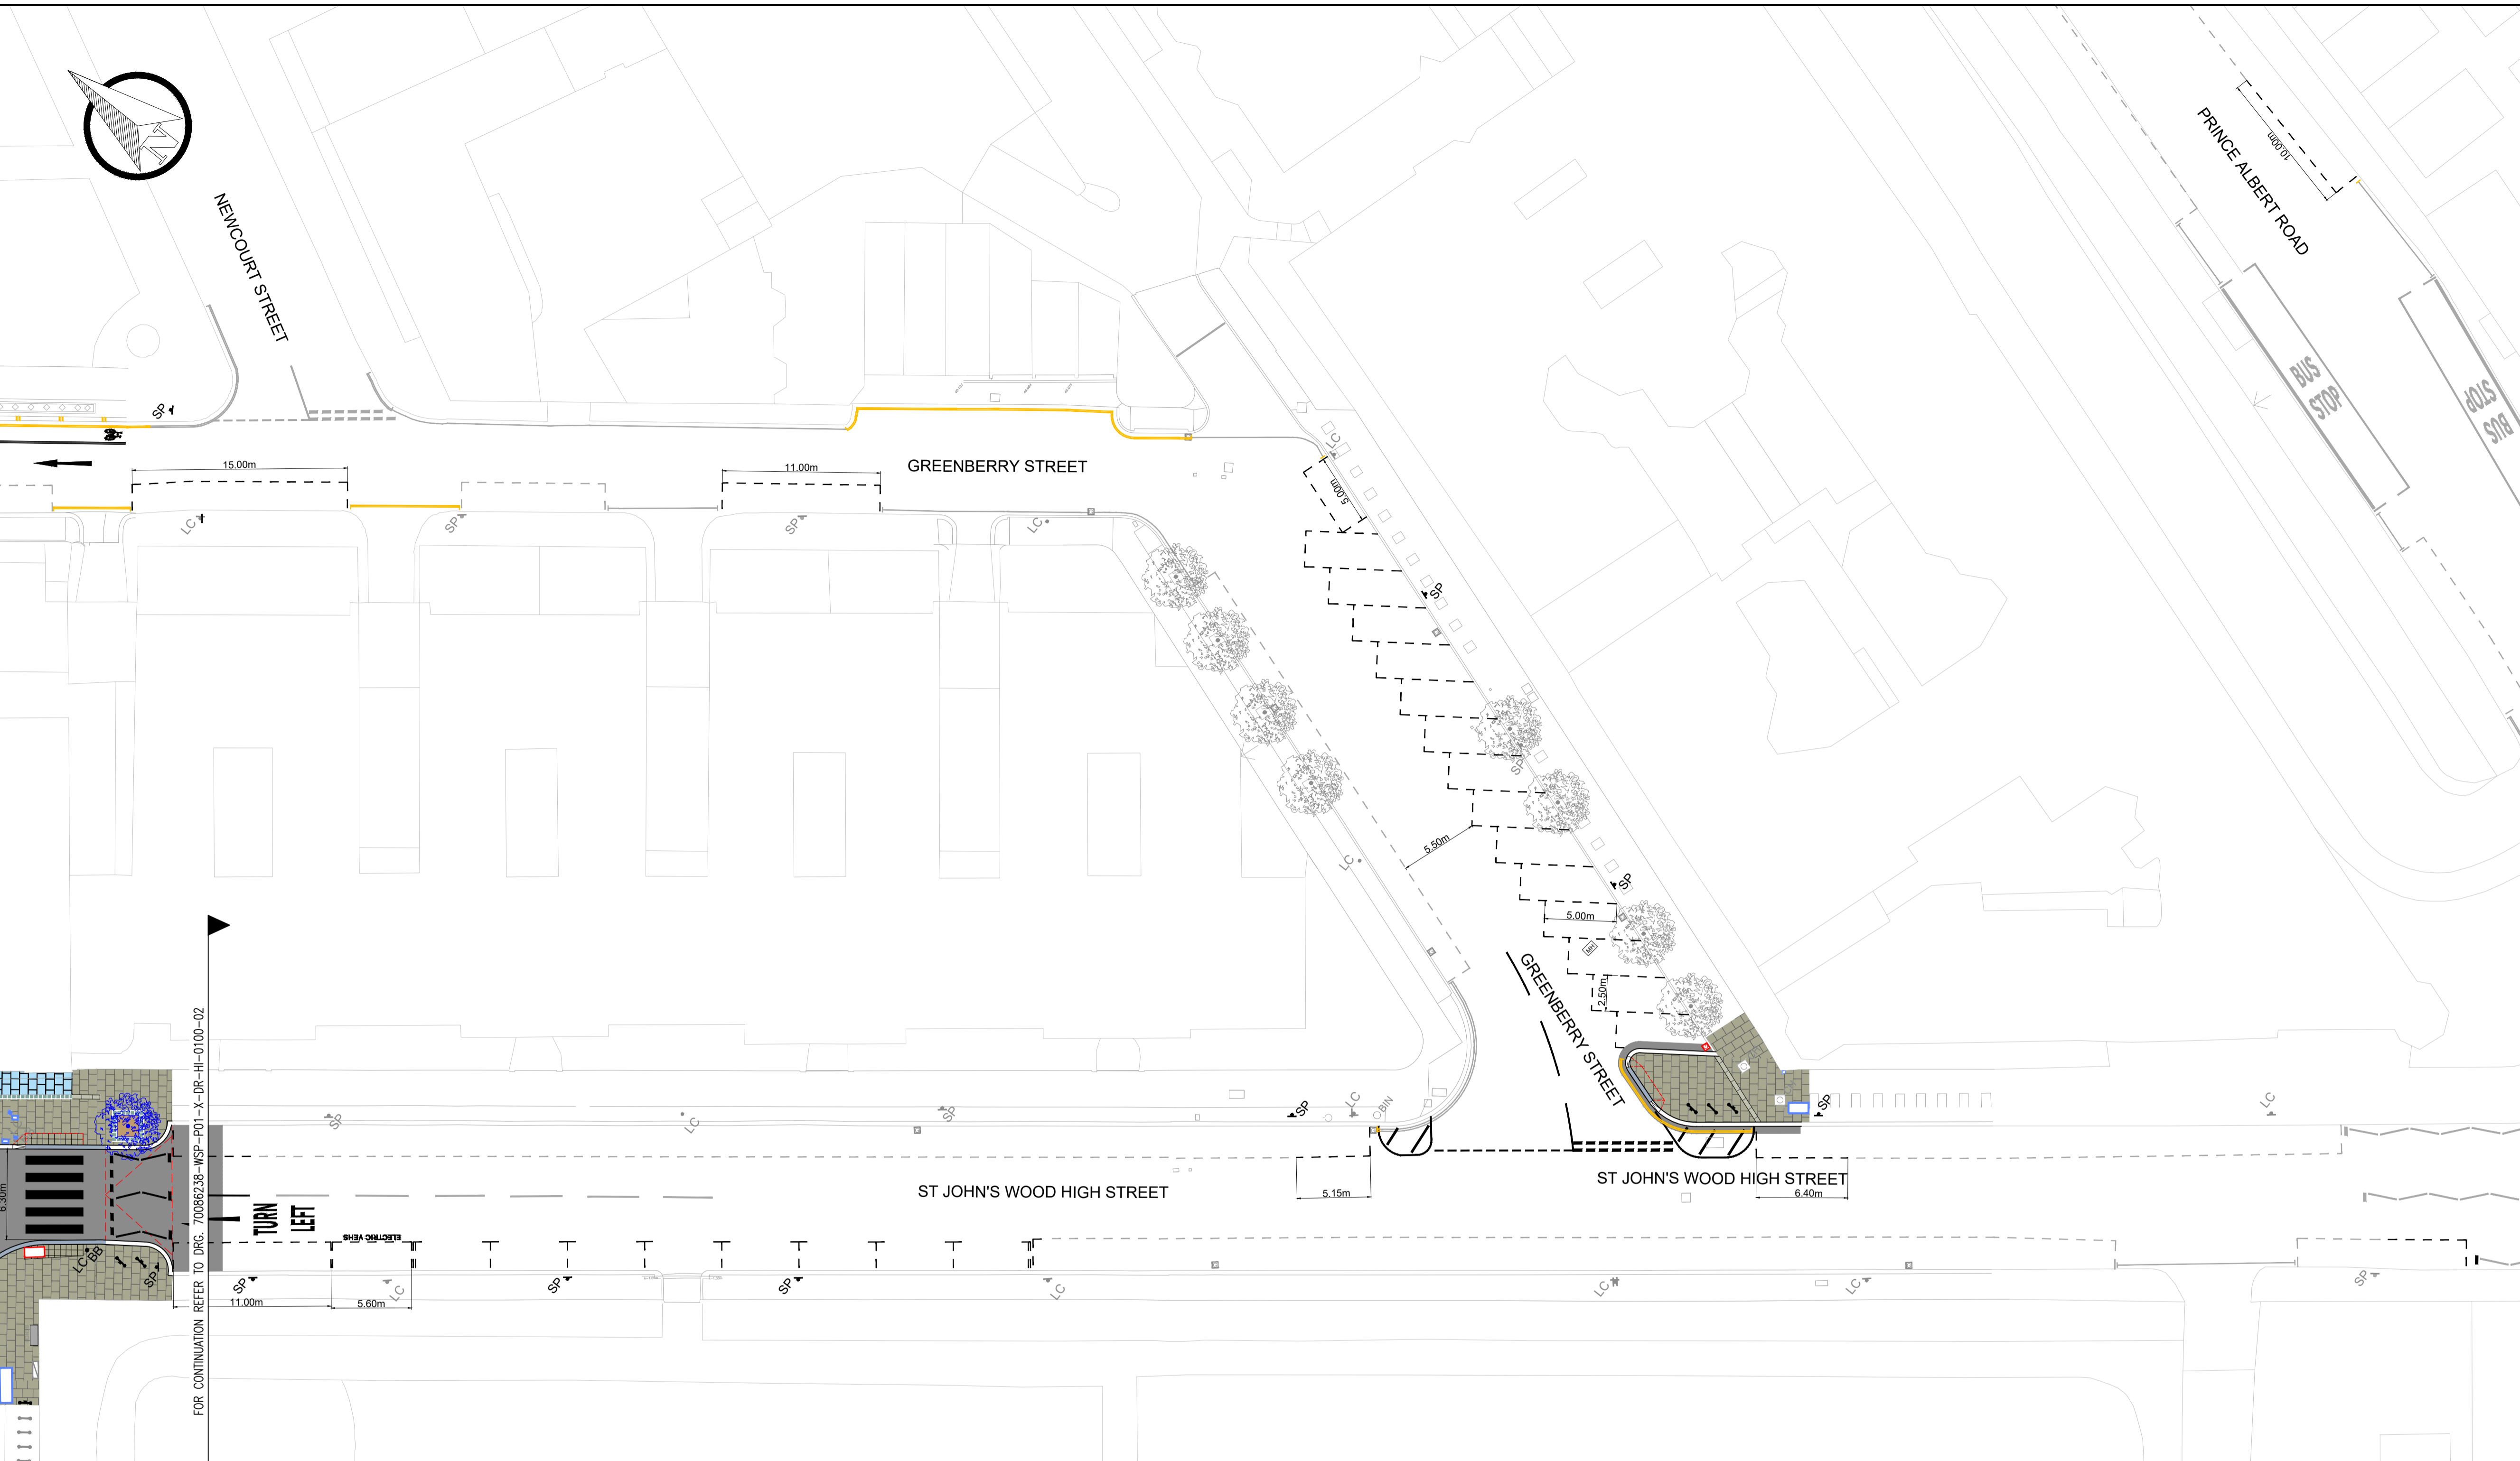

### KEY

- EXISTING FORECOURT (NO CIVIL WORKS)
- EXISTING COBBLED STONE SETTS TO BE RE-LAID TO SUIT NEW LEVELS OVER 50mm STEINTEC BEDDING AND GROUTING MORTAR
- EXISTING GRANITE SETTS TO BE RETAINED
- EXISTING PRIVATE FORECOURT TO BE RE-PAVED WITH PROPOSED 750x600x63mm ASP SLABS LAID ON 100mm C16/20 CONCRETE BASE AND 50mm SAND/CEMENT BEDDING
- PROPOSED 750x600x63mm FIBRE REINFORCED ASP SLABS LAID ON 150mm C16/20 CONCRETE BASE AND 50mm SAND/CEMENT BEDDING
- PROPOSED 750x600x50mm YORKSTONE PAVERS LAID ON 75mm THICK C8/10 CONCRETE AND 30mm TYPE 35 HIGH STRENGTH BEDDING MORTAR AND 6 TO 8MM TYPE 40 GROUTING COLOUR BUFF GREY
- EXISTING YORKSTONE BEDDING TO BE RELAID
- PROPOSED 300x600x75mm GREY BEIGE GRANITE LAID ON 150mm C16/20 CONCRETE BASE AND 50mm STEINTEC BEDDING AND GROUTING MORTAR WITH HD GUARD
- PROPOSED 250x150x100mm GREY BEIGE GRANITE LAID ON 150mm C16/20 CONCRETE BASE AND 50mm STEINTEC BEDDING AND GROUTING MORTAR WITH HD GUARD
- PROPOSED 300x300x70mm CAITHNESS FLAG LAID ON 150mm C16/20 CONCRETE BASE AND 50mm STEINTEC BEDDING AND GROUTING MORTAR WITH HD GUARD
- PROPOSED 50mm HRA 35/14 F surf 40/60 PMB + WTR2 CARRIAGEWAY SURFACE WITH 14/20 PRE-COATED CHIPPINGS SURFACE COURSE ON EXISTING BINDER COURSE (SPEC TO BE CONFIRMED WITH WCC & FMC BEFORE CONSTRUCTION)
- PROPOSED 600mm NEW CARRIAGEWAY 50mm HRA 35/14 F surf 40/60 PMB + WTR2 CARRIAGEWAY SURFACE WITH 14/20 PRE-COATED CHIPPINGS SURFACE COURSE, 50mm (MIN) HRA 50/14 bin 40/60 PMB WTR2 BINDER COURSE, 200mm SRC C20 CONCRETE BASE AND 300mm TYPE 1 (SPEC TO BE CONFIRMED WITH WCC & FMC BEFORE CONSTRUCTION)
- EXISTING PRIVATE FORECOURT TO BE PAVED WITH A LAYER OF CONCRETE UP TO 70mm (SPEC TO BE CONFIRMED ON SITE)
- PROPOSED 400x400x63mm FIBRE REINFORCED ASP BLISTER TACTILE SLABS LAID ON 150mm C16/20 CONCRETE BASE AND 50mm SAND/CEMENT BEDDING

S6-P01	12.02.2024		FIRST ISSUE		
REV	DATE	BY	DESCRIPTION	CHK	APP

DRAWING STATUS: **AS BUILT**

25 Mandela Way, London, SE1 5SZ  
www.fmconway.co.uk www.wsp.com

CLIENT:

PROJECT: **ST JOHNS WOOD HIGH STREET PUBLIC REALM IMPROVEMENTS**

TITLE: **GENERAL ARRANGEMENT SHEET 03 OF 03**

SCALE @ A1	DATE	DESIGN/DRAWN	CHECKED	APPROVED	SHEET
1:250	12.02.2024				A1
WSP PROJECT NO.	FMC PROJECT NO.	WCC PROJECT NO.			
70086238	WWESA2867	C.WD13434			
DRAWING NO.	REV				
70086238-WSP-P01-X-DR-HI-0100-03	S6-P01				

### ADDITIONAL KEY

- PROPOSED SINUSOIDAL RAMP
- PROPOSED NEW 150x300mm GRANITE KERB LAID ON 150mm C16/20 WET LEAN CONCRETE
- PROPOSED NEW 300x200mm GRANITE KERB LAID ON 150mm C16/20 WET LEAN CONCRETE
- PROPOSED NEW 300x200mm FLUSH GRANITE KERB WITH DROPPER LAID ON 150mm C16/20 WET LEAN CONCRETE
- PROPOSED PRIMROSE YELLOW LINE MARKING
- PROPOSED WHITE LINE MARKING
- PROPOSED 300x750x63mm FIBRE REINFORCED ASP SLABS LAID ON 150mm C16/20 CONCRETE BASE AND 50mm SAND/CEMENT BEDDING
- MH NEW 900x600mm MANHOLE WITH HEAVY DUTY DOUBLE RECESSED COVER AND FRAME ACCORDING TO WESTMINSTER STANDARD DETAIL SD-05-04
- PROPOSED GULLY POT TYPE 1 (450mm DIA x 900mm DEPTH) WITH CLASS D400 HEAVY DUTY FRAME AND CYCLE FRIENDLY COVER (450 x 450mm)
- PROPOSED GULLY POT TYPE 1 (450mm DIA x 900mm DEPTH) WITH CLASS D400 HEAVY DUTY FRAME AND STANDARD COVER (450 x 450mm)
- PROPOSED GULLY POT TYPE 2 (375mm DIA x 750mm DEPTH) WITH 300x300mm PEDESTRIAN FRAME FACTA D DU507C DUREY CASTINGS GRATING AND FRAME
- PROPOSED BRICK CATCH PIT (WESTMINSTER STANDARD DRAWING SD-05-21) WITH INSTALL CLASS D400 HEAVY DUTY FRAME AND CYCLE FRIENDLY COVER (450 x 450mm)
- EXISTING GULLY FRAME AND COVER TO BE REPLACED WITH CLASS D400 CYCLE FRIENDLY FRAME AND COVER GRATING
- EXISTING VENT TO BE RAISED/LOWERED TO SUIT NEW LEVELS
- PROPOSED SIGN AND POST
- PROPOSED LAMP COLUMN
- PROPOSED COMBINED LAMP COLUMN AND BELISHA BEACON
- PROPOSED DORIC BOLLARD
- PROPOSED BELISHA BEACON (FOR DETAILS REFER TO 70086238-WSP-P01-X-DR-LI-1300)
- PROPOSED MINI FEEDER PILLAR
- PROPOSED WALL MOUNTED LIGHT
- PROPOSED TYPE 1 CYCLE STAND
- PROPOSED TYPE 2 CYCLE STAND
- PROPOSED STAINLESS STUD FLAT DELINEATOR STUD
- PROPOSED TREE BETULA KENAIKA (LEFT) / MAGNOLIA KOBUS (MIDDLE) / SORBUS INTERMEDIA (RIGHT)
- PROPOSED 1.2x1.2M ARBORESIN TREE GRILLE, FILLED WITH ADDAFLEX MATERIAL. COLOUR GS/01/52 A FOR TREE PIT
- PROPOSED 1.5x1.5M ARBORESIN TREE GRILLE, FILLED WITH ADDAFLEX MATERIAL. COLOUR GS/01/52 A FOR TREE PIT
- PROPOSED ADDAFLEX MATERIAL. COLOUR GS/01/52 A LAID ON 100mm OF 40mm FREE DRAINING CRUSHED STONE
- PROPOSED 2.58M WESTMINSTER BENCH WITH CENTRE LEG (BACKLESS)
- PROPOSED 2.58M WESTMINSTER BENCH WITH CENTRE LEG (WITH A BACK)
- RELOCATED LITTER BIN
- RELOCATED STREETNAME PLATE (LOCATION TO BE CONFIRMED WITH WCC)
- EXISTING COVER TO BE RAISED/LOWERED TO SUIT NEW LEVELS
- EXISTING SERVICE COVER TO BE RECESSED
- EXISTING COAL HOLE TO REMAIN IN SITU
- EXISTING KERB TO BE RETAINED
- EXISTING LINE MARKING
- EXISTING BOLLARD
- EXISTING WESTMINSTER BOLLARD
- EXISTING LAMP COLUMN / EXISTING POST
- EXISTING BELISHA BEACON
- EXISTING SIGN AND POST
- EXISTING ELECTRICAL CHARGING POINT
- EXISTING GULLY
- EXISTING HOPPER BOX
- EXISTING CYCLE STAND
- EXISTING BIN
- EXISTING BENCH
- EXISTING TELEPHONE BOX
- EXISTING ELECTRICAL CABINET
- EXISTING GRIT BOX
- EXISTING CATENARY FESTIVE LIGHTING TO BE RETAINED

This map is reproduced from Ordnance Survey material with the permission of Ordnance Survey on behalf of the Controller of Her Majesty's Stationery Office © Crown copyright. Unauthorised reproduction infringes Crown copyright and may lead to prosecution or civil proceedings. (WCC/LA 100019597)